

Subject:

**IMAGE AND TEXT ERROR IN ACCESSORY RUNNING BOARD
INSTALLATION INSTRUCTIONS**

Service Alert No.: SA-039/24

Last Issued : 06/17/2024

BULLETIN NOTES



APPLICABLE MODEL(S)/VINS

2024-2025 CX-90

2025 CX-70

DESCRIPTION

The image and text are incorrect in the original installation instruction for Section 9, step 16 where it shows a square head nut, washer, and flange nut. The washer is not used in this portion of the installation and the image and bolt assembly description is incorrect. The correct image shown below in image on the right.

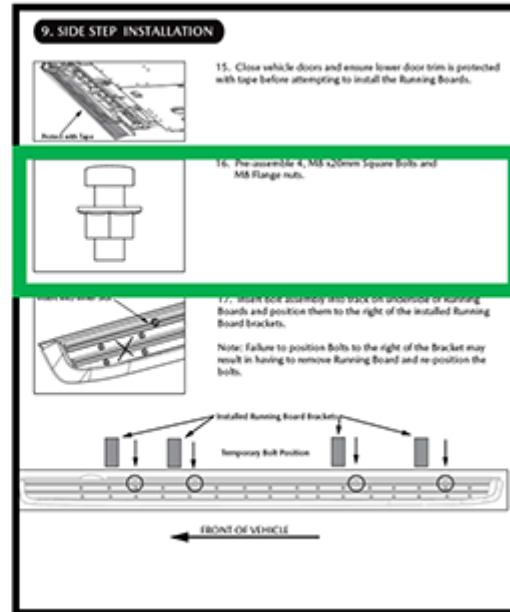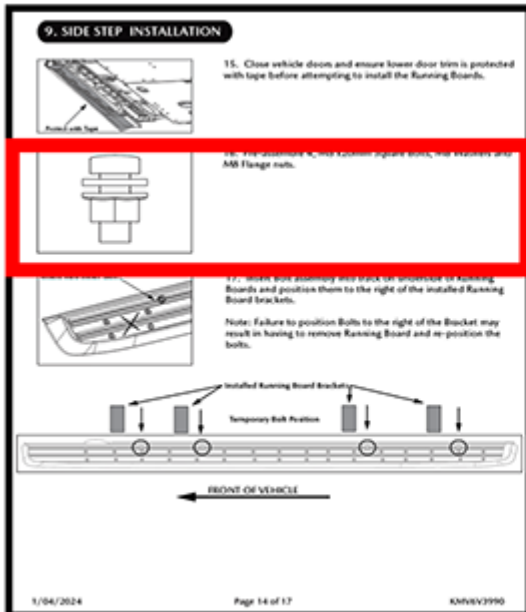

CONSUMER NOTICE: The information and instructions in this bulletin are intended for use by skilled technicians. Mazda technicians utilize the proper tools/ equipment and take training to correctly and safely maintain Mazda vehicles. These instructions should not be performed by "do-it-yourselfers." Customers should not assume this bulletin applies to their vehicle or that their vehicle will develop the described concern. To determine if the information applies, customers should contact their nearest authorized Mazda dealership. Mazda North American Operations reserves the right to alter the specifications and contents of this bulletin without obligation or advance notice. All rights reserved. No part of this bulletin may be reproduced in any form or by any means, electronic or mechanical---including photocopying and recording and the use of any kind of information storage and retrieval system ---without permission in writing.